

Bidding Requirements, Contract Forms and Conditions of the Contract
ADDENDUM
Section 00900

ADDENDUM No. #3

Date June 10, 2016

City of Austin

Project Name Eliza Spring Outlet Daylighting

C.I.P. No. CIP 6660.046 Project/Solicitation Number: CSP 6100 CLMB321

This Addendum forms a part of the Contract and corrects or modifies original Bid Documents, dated May 9, 2016. Acknowledge receipt of this addendum in space provided on bid form. Failure to do so may subject bidder to disqualification.

A. Project Manual Revisions:

- 1) Volume 1, Section 00020CSP, Request for Proposals

--Delete page 2 and replace with attached page 2.

B. Drawing Revisions:

- 1) Delete Sheet X 1.1, and replace with the attached Sheet X 1.1.

This addendum consists of 3 page(s)/sheet(s).

John C. Parrish

Approved by OWNER

[Signature]

Approved by ENGINEER/ARCHITECT



END

calendar day for failure to achieve final completion within the stipulated calendar days after substantial completion, in accordance with the Proposal Form.

3. SOLICITATION DOCUMENTS

Solicitation Documents are available in CD format at no cost and may be obtained at One Texas Center, 505 Barton Springs Rd., Suite 1045-B, Austin, TX 78704.

At the time Solicitation Documents are obtained, Offerors must provide a working email address, so that they will receive any Addenda and/or Clarifications issued by the Owner.

4. SUBMISSION OF PROPOSAL

The Offeror must submit one (1) original signature copy of their submittal, stamped "Original", one (1) duplicate copy, stamped "Copy", and one (1) digital/electronic version on CD or Flash Drive in a sealed container. Proposals must be received at the following location prior to the date and time set forth below:

**Capital Contracting Office
Contract Procurement Division
ATTN: Lynn Rich
One Texas Center, 505 Barton Springs Rd., Suite 1045-C
Austin, Texas 78704**

DUE DATE:	June 17th, 2016
PRIOR TO:	3:00 PM

PROPOSALS AND COMPLIANCE PLANS RECEIVED AFTER THE DATE AND TIME STATED ABOVE WILL NOT BE ACCEPTED FOR EVALUATION. The time stamp clock in Suite 1045-C, is the time of record and is verified daily with www.time.gov, the official U.S. time.

The Owner will receive, publicly open, and read aloud the names of the Offerors and their proposed prices in the Congress Conference Room, Suite 1045-C, One Texas Center, 505 Barton Springs Rd, Austin, Texas 78704.


It is the sole responsibility of the Offeror to ensure timely delivery of Proposal. Owner will not be responsible for failure of service on the part of the U.S. Post Office, courier services, or any other form of delivery service chosen by Offeror.

5. AUTHORIZED CONTACT PERSONS

The persons listed below may be contacted for information regarding the Invitation for Proposals. If the Offeror contacts any other City employee, including Council Members and members of Boards and Commissions, the Offeror may be found in violation of Ordinance No. 20111110-052, dated November 10, 2011, regarding Anti-Lobbying and Procurement. The text of that Ordinance may be viewed at

<http://www.cityofaustin.org/edims/document.cfm?id=161145>.

PROJECT MANAGER:	Jules Parrish	512-974-9385
CONTRACT PROCUREMENT REP.:	Lynn Rich	512-974-7009

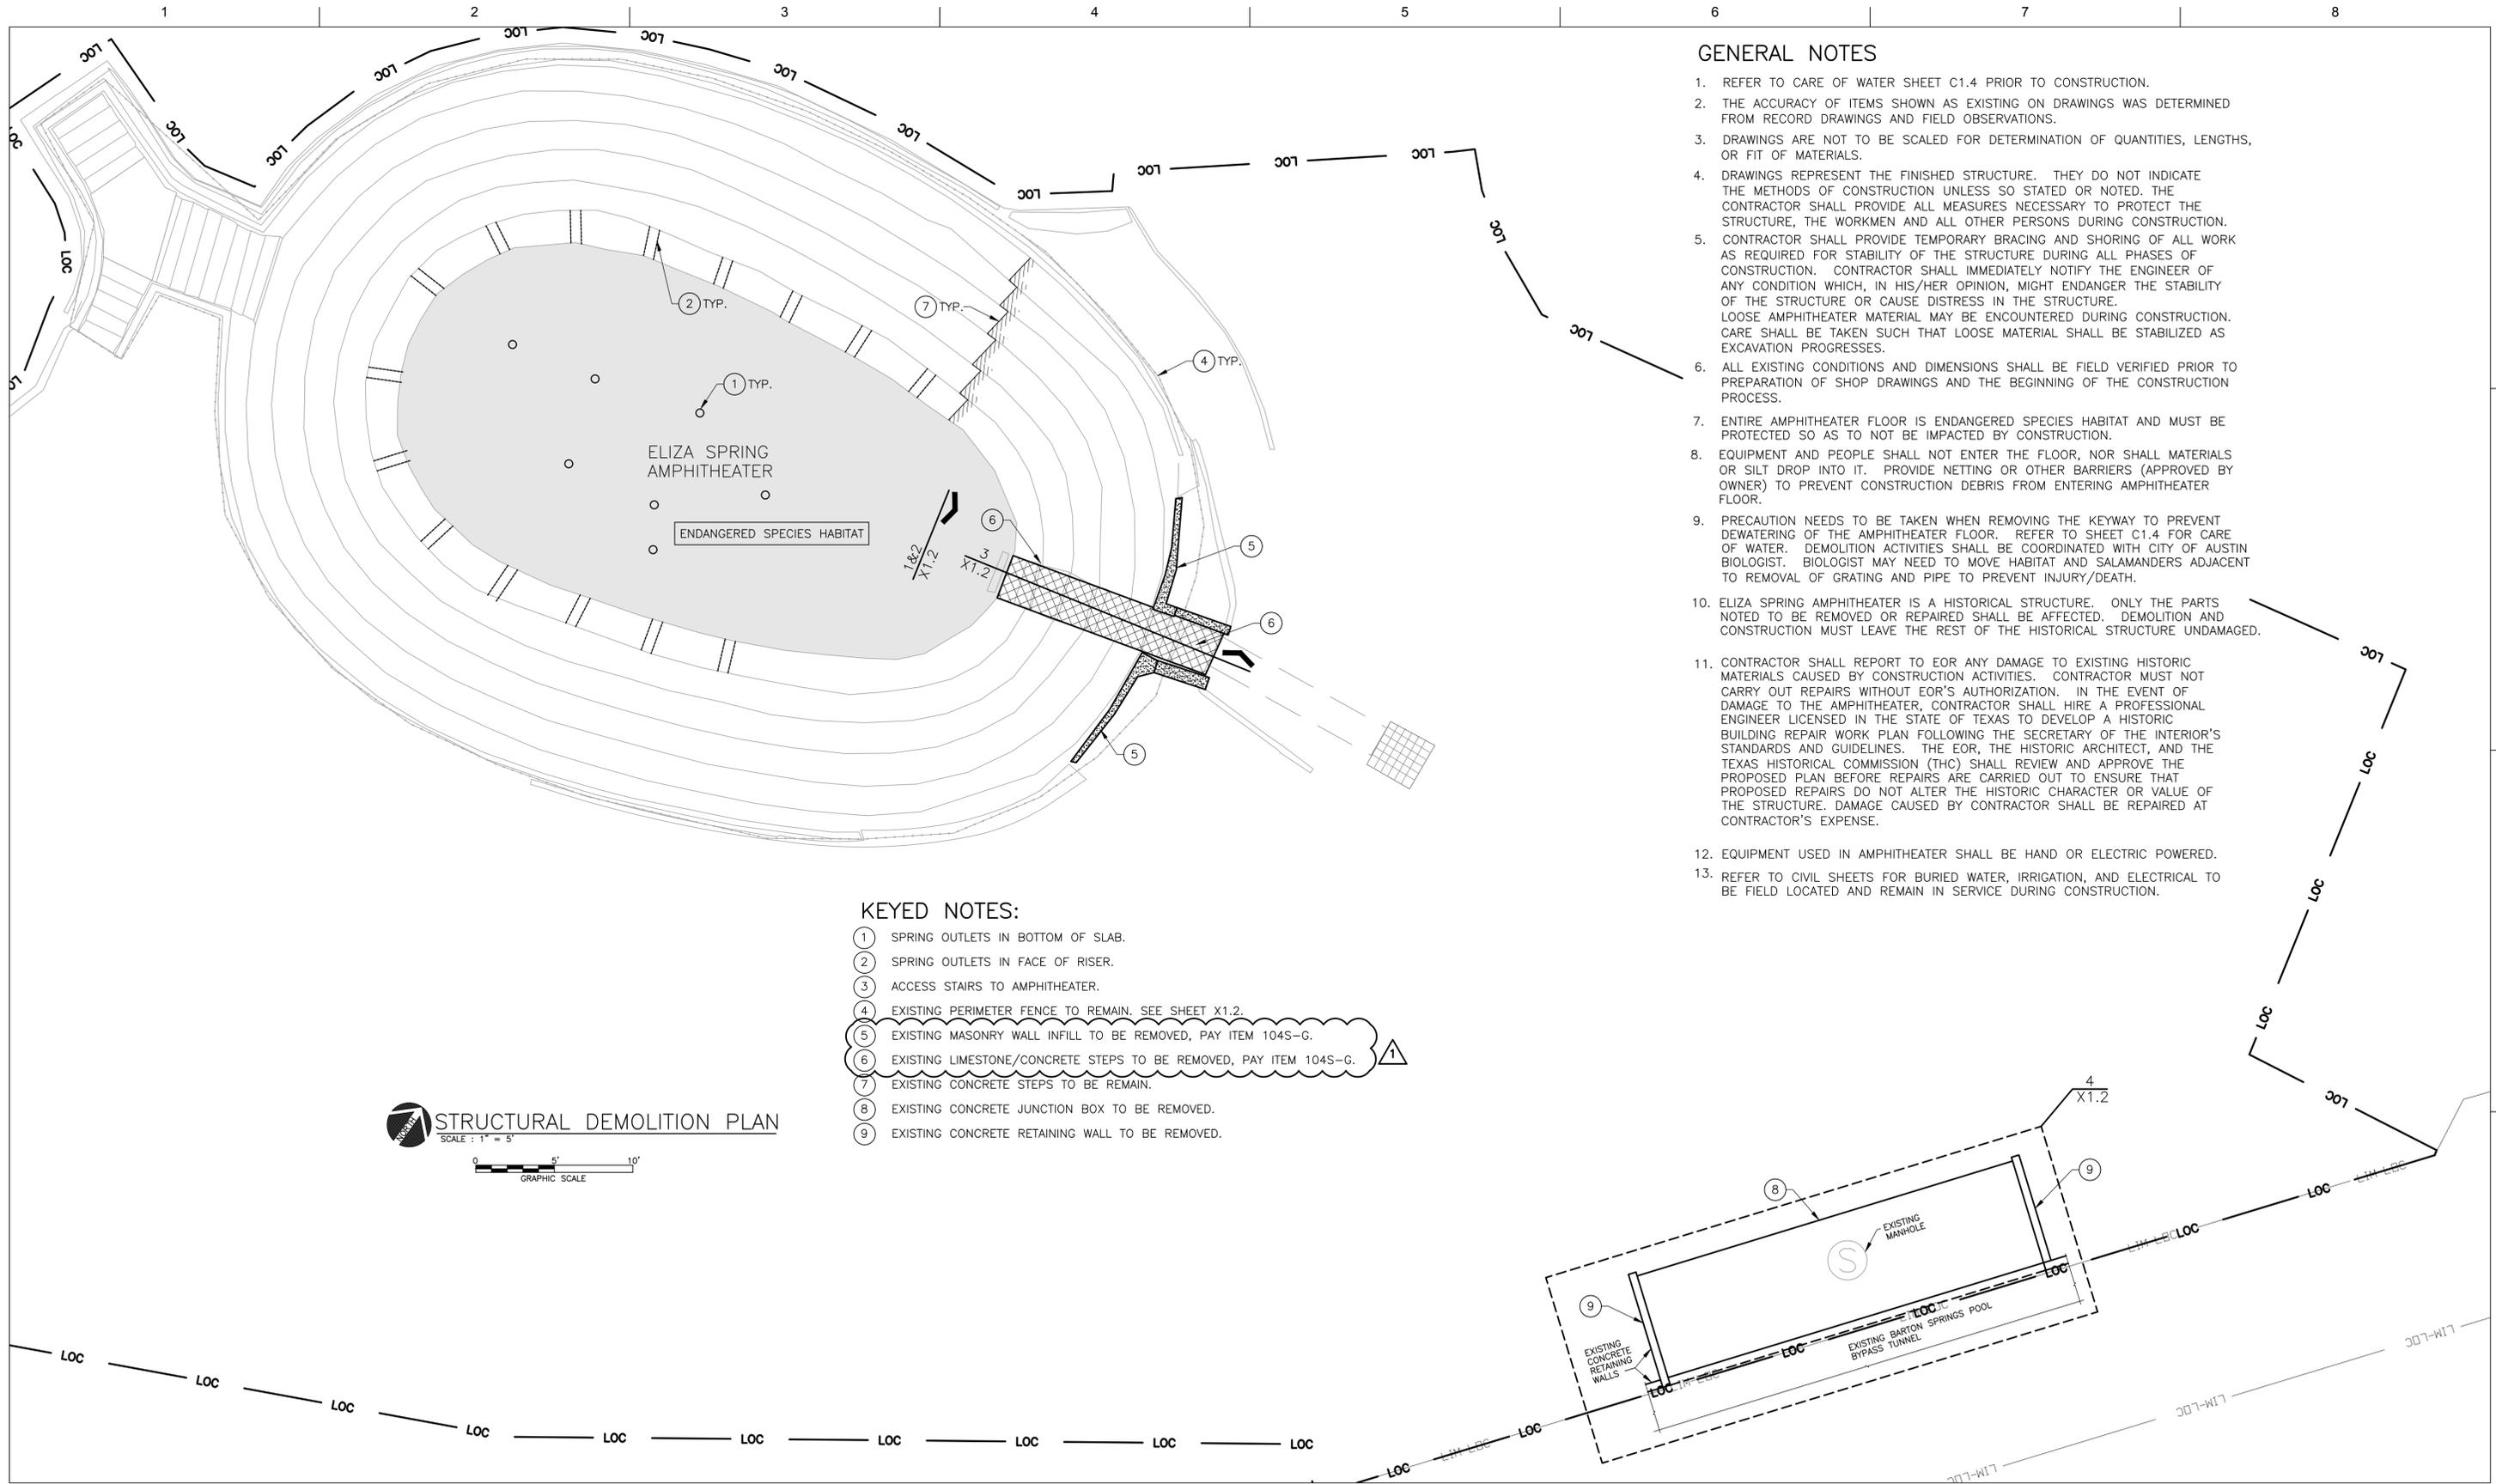

GENERAL NOTES

1. REFER TO CARE OF WATER SHEET C1.4 PRIOR TO CONSTRUCTION.
2. THE ACCURACY OF ITEMS SHOWN AS EXISTING ON DRAWINGS WAS DETERMINED FROM RECORD DRAWINGS AND FIELD OBSERVATIONS.
3. DRAWINGS ARE NOT TO BE SCALED FOR DETERMINATION OF QUANTITIES, LENGTHS, OR FIT OF MATERIALS.
4. DRAWINGS REPRESENT THE FINISHED STRUCTURE. THEY DO NOT INDICATE THE METHODS OF CONSTRUCTION UNLESS SO STATED OR NOTED. THE CONTRACTOR SHALL PROVIDE ALL MEASURES NECESSARY TO PROTECT THE STRUCTURE, THE WORKMEN AND ALL OTHER PERSONS DURING CONSTRUCTION.
5. CONTRACTOR SHALL PROVIDE TEMPORARY BRACING AND SHORING OF ALL WORK AS REQUIRED FOR STABILITY OF THE STRUCTURE DURING ALL PHASES OF CONSTRUCTION. CONTRACTOR SHALL IMMEDIATELY NOTIFY THE ENGINEER OF ANY CONDITION WHICH, IN HIS/HER OPINION, MIGHT ENDANGER THE STABILITY OF THE STRUCTURE OR CAUSE DISTRESS IN THE STRUCTURE. LOOSE AMPHITHEATER MATERIAL MAY BE ENCOUNTERED DURING CONSTRUCTION. CARE SHALL BE TAKEN SUCH THAT LOOSE MATERIAL SHALL BE STABILIZED AS EXCAVATION PROGRESSES.
6. ALL EXISTING CONDITIONS AND DIMENSIONS SHALL BE FIELD VERIFIED PRIOR TO PREPARATION OF SHOP DRAWINGS AND THE BEGINNING OF THE CONSTRUCTION PROCESS.
7. ENTIRE AMPHITHEATER FLOOR IS ENDANGERED SPECIES HABITAT AND MUST BE PROTECTED SO AS TO NOT BE IMPACTED BY CONSTRUCTION.
8. EQUIPMENT AND PEOPLE SHALL NOT ENTER THE FLOOR, NOR SHALL MATERIALS OR SILT DROP INTO IT. PROVIDE NETTING OR OTHER BARRIERS (APPROVED BY OWNER) TO PREVENT CONSTRUCTION DEBRIS FROM ENTERING AMPHITHEATER FLOOR.
9. PRECAUTION NEEDS TO BE TAKEN WHEN REMOVING THE KEYWAY TO PREVENT DEWATERING OF THE AMPHITHEATER FLOOR. REFER TO SHEET C1.4 FOR CARE OF WATER. DEMOLITION ACTIVITIES SHALL BE COORDINATED WITH CITY OF AUSTIN BIOLOGIST. BIOLOGIST MAY NEED TO MOVE HABITAT AND SALAMANDERS ADJACENT TO REMOVAL OF GRATING AND PIPE TO PREVENT INJURY/DEATH.
10. ELIZA SPRING AMPHITHEATER IS A HISTORICAL STRUCTURE. ONLY THE PARTS NOTED TO BE REMOVED OR REPAIRED SHALL BE AFFECTED. DEMOLITION AND CONSTRUCTION MUST LEAVE THE REST OF THE HISTORICAL STRUCTURE UNDAUNAGED.
11. CONTRACTOR SHALL REPORT TO EOR ANY DAMAGE TO EXISTING HISTORIC MATERIALS CAUSED BY CONSTRUCTION ACTIVITIES. CONTRACTOR MUST NOT CARRY OUT REPAIRS WITHOUT EOR'S AUTHORIZATION. IN THE EVENT OF DAMAGE TO THE AMPHITHEATER, CONTRACTOR SHALL HIRE A PROFESSIONAL ENGINEER LICENSED IN THE STATE OF TEXAS TO DEVELOP A HISTORIC BUILDING REPAIR WORK PLAN FOLLOWING THE SECRETARY OF THE INTERIOR'S STANDARDS AND GUIDELINES. THE EOR, THE HISTORIC ARCHITECT, AND THE TEXAS HISTORICAL COMMISSION (THC) SHALL REVIEW AND APPROVE THE PROPOSED PLAN BEFORE REPAIRS ARE CARRIED OUT TO ENSURE THAT PROPOSED REPAIRS DO NOT ALTER THE HISTORIC CHARACTER OR VALUE OF THE STRUCTURE. DAMAGE CAUSED BY CONTRACTOR SHALL BE REPAIRED AT CONTRACTOR'S EXPENSE.
12. EQUIPMENT USED IN AMPHITHEATER SHALL BE HAND OR ELECTRIC POWERED.
13. REFER TO CIVIL SHEETS FOR BURIED WATER, IRRIGATION, AND ELECTRICAL TO BE FIELD LOCATED AND REMAIN IN SERVICE DURING CONSTRUCTION.

KEYED NOTES:

- ① SPRING OUTLETS IN BOTTOM OF SLAB.
- ② SPRING OUTLETS IN FACE OF RISER.
- ③ ACCESS STAIRS TO AMPHITHEATER.
- ④ EXISTING PERIMETER FENCE TO REMAIN, SEE SHEET X1.2.
- ⑤ EXISTING MASONRY WALL INFILL TO BE REMOVED, PAY ITEM 104S-G.
- ⑥ EXISTING LIMESTONE/CONCRETE STEPS TO BE REMOVED, PAY ITEM 104S-G.
- ⑦ EXISTING CONCRETE STEPS TO BE REMAIN.
- ⑧ EXISTING CONCRETE JUNCTION BOX TO BE REMOVED.
- ⑨ EXISTING CONCRETE RETAINING WALL TO BE REMOVED.

STRUCTURAL DEMOLITION PLAN
 SCALE : 1" = 5'
 GRAPHIC SCALE

Jose I. Guerra, Inc.
 Consulting Engineers
 2401 South IH-35 Suite 210
 Austin, Texas 78741
 (512) 445-2090
 Structural • Civil • Mechanical • Electrical
 TBPE FIRM F-3



ISSUE	DATE	DESCRIPTION
1	6/9/2016	ISSUED FOR ADDENDUM #3

PROJECT MANAGER	RJG
DESIGNED BY	BMB
DRAWN BY	FS
CHECKED BY	RJG
DATE	06-09-2016
PROJECT NUMBER	220162



**ELIZA SPRING
 OUTLET DAYLIGHTING
 SPC-2012-0104D (R2)**
 Austin, Texas

**STRUCTURAL
 DEMOLITION PLAN**
 FILENAME
 SCALE AS NOTED

NEW SHEET
 105 OF 138
X1.1